

1 ARENA PARADE

Letchworth Garden City
Hertfordshire
SG6 3BY



TO LET.

**REFURBISHED SELF-CONTAINED GROUND RETAIL UNIT
WITH RETURN FRONTAGE
NEWLY GLAZED WINDOWS AND DOOR**

779 SQ FT (72.46 SQ M)



For further information please contact: Tereza Halewood

T: 01438 794588

E: tereza.halewood@brownandlee.com

M: 07825 555173

W: www.brownandlee.com

Location

Letchworth was the world's first Garden City founded in 1903. It is located in North Hertfordshire, approximately 32 miles north of London. The town has direct access to the A1(M), which offers links to M25, 20 minutes to the south. Letchworth mainline railway station provides a fast service to London Kings Cross (36 minutes) and is well located for the international airports at both Luton and Stansted.

The property is in Arena Parade, located between Broadway and Eastcheap, fronting onto a public car park.

Description

The property comprises a ground floor self-contained retail lock-up unit with WC facility. There is a shared small yard at the rear of the property. The property benefits from return frontage onto Arena Parade and Broadway.

The property has been refurbished to white box specification with newly glazed windows and door.

Accommodation

The approximate net useable areas are as follows: -

Ground Floor

Net internal area	779 sq ft	72.46 sq m
-------------------	-----------	------------

Tenure

Our clients can offer a new lease for a term to be agreed.

Rental

£20,000 per annum, exclusive.

Service Charge

There is a service charge payable. The cost is £1,121 per annum.

Rates

We understand from the Valuation Office Agency website (www.voa.gov.uk) that the rateable value is £11,500. The UBR for 2023/24 is 51.2p in the £. Rates payable may be subject to transitional arrangements and/or small business relief, which should be verified with the Charging Authority. Assessments may be subject to appeal.

Energy Performance Certificate (EPC)


A copy of the EPC will be provided.

Important

The services, fixtures, fittings, appliances and other items of equipment referred to have not been tested by this firm and therefore no warranty can be given in respect of their condition. Prospective tenants/purchasers should satisfy themselves as to their condition.

VAT

Unless otherwise stated all prices and rents quoted are exclusive of Value Added Tax. Any intending lessees or purchasers must satisfy themselves as to the incidence of VAT in respect of any transaction.

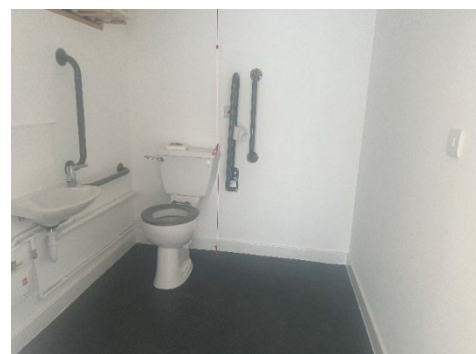

Brown & Lee Commercial Property Consultants LLP


15 Meadway Court, Rutherford Close, Stevenage, Hertfordshire, SG1 2EF | Ref no: 14374E

Every effort has been made to ensure that these particulars are correct, but their accuracy is not guaranteed, and they do not form part of any contract. All prices and rentals are quoted exclusive of VAT | Regulated by RICS.




NOTES

1. No dimensions are to be scaled from this drawing.
2. Contractors must verify all figured dimensions on site before commencing any work or making any shop drawings.
3. This drawing is the sole copyright of Savills and no part may be reproduced without the written consent of the above.
4. Site Location Plans are prepared from the Ordnance Survey Map with the sanction of the Controller of H.M. Stationary Office. Crown Copyright Reserved.

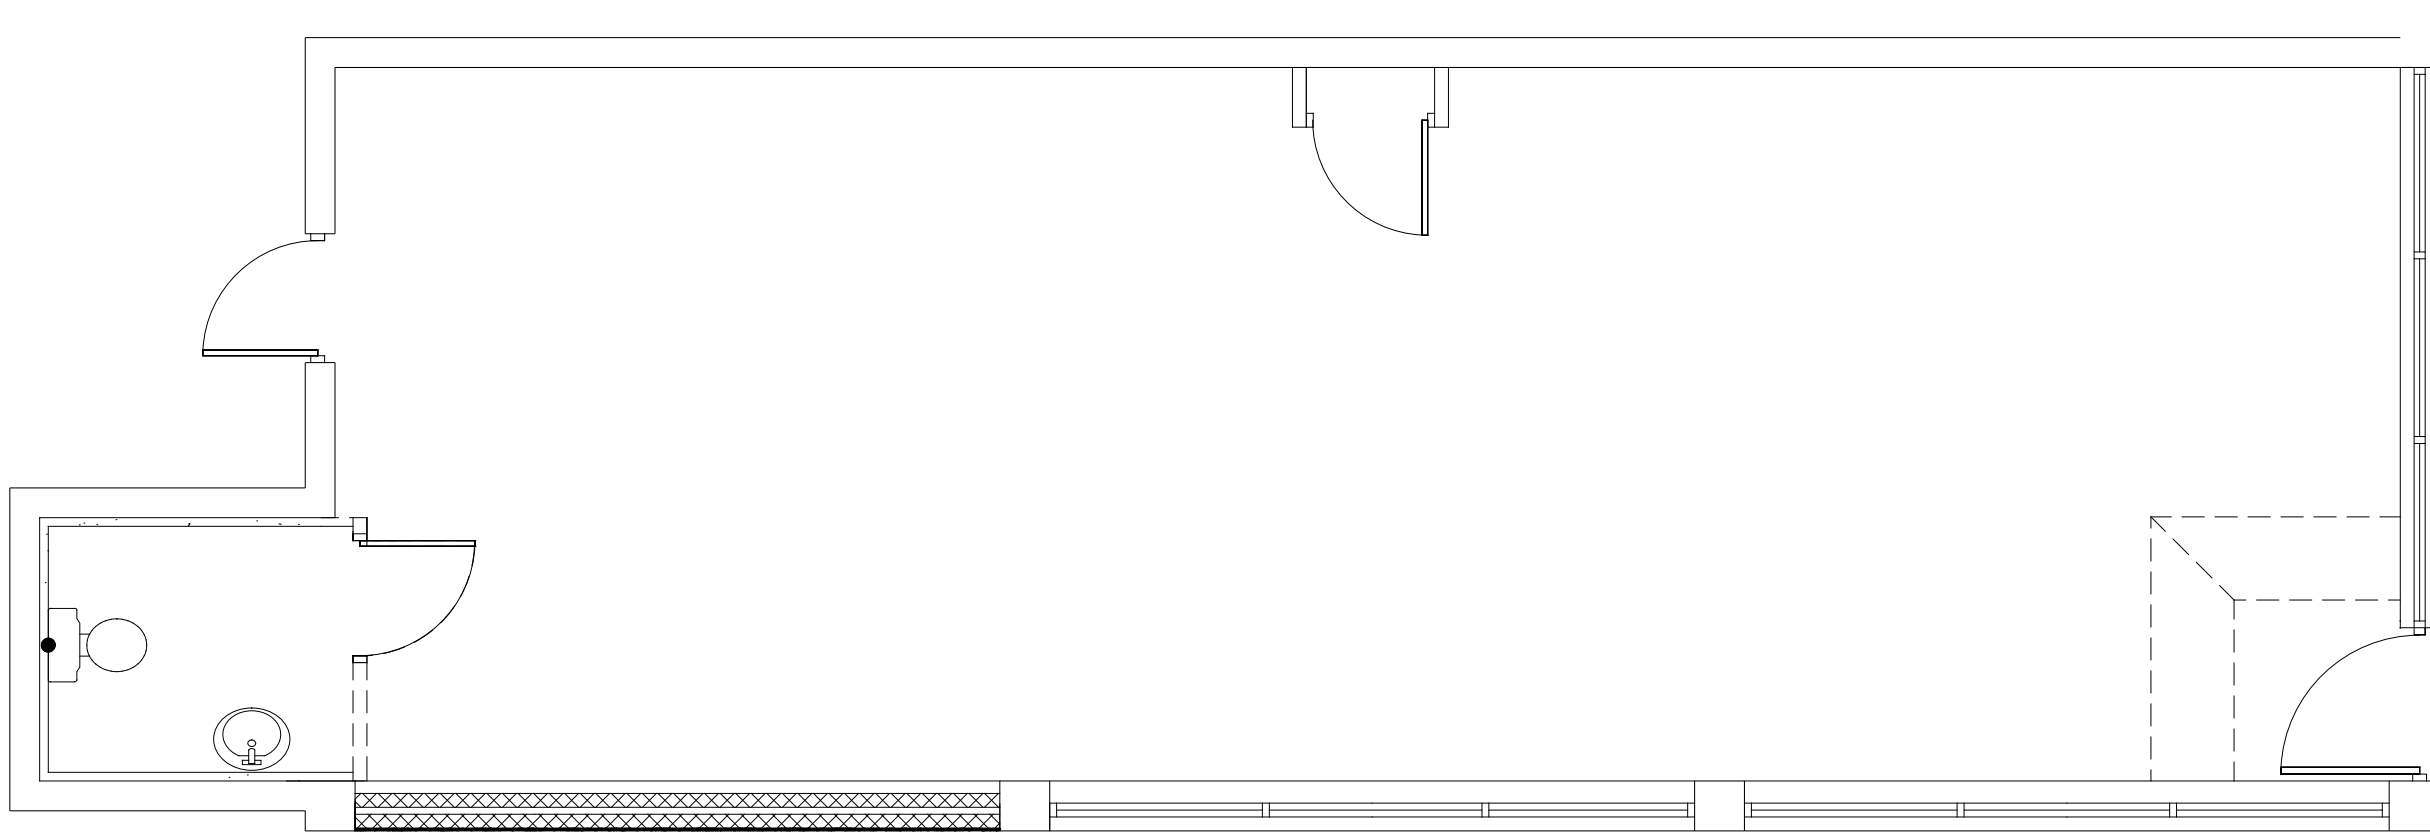

GROUND FLOOR - AS BUILT

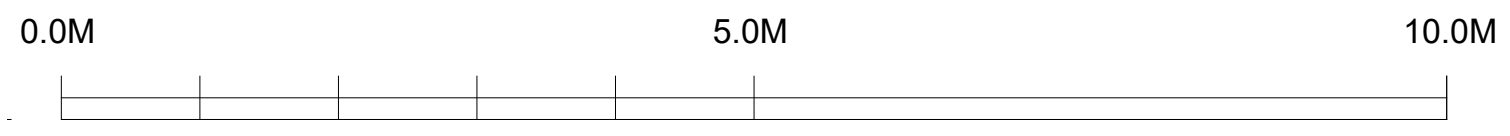

Rev	Description	By	Date
Drawing Status			
AS BUILT			
 <p>savills BUILDING & PROJECT CONSULTANCY Savills (UK) Limited Unex House, 132-134 Hills Road, Cambridge, CB2 8PA</p> <p>Telephone: + 44 (0)1223 347 093 Fax: + 44 (0)7890 984 209 www.savills.co.uk</p>			
Client			
- LGCHF			
Project			
- 1 Arena Parade, Letchworth			
Drawing Title			
- As Built General Arrangement Plan			
Scale	Date	Drawn	Checked
1:50 @ A3	09.08.2024	BY	NH
Drawing Number	Rev.	Project Number	
AL-01			